
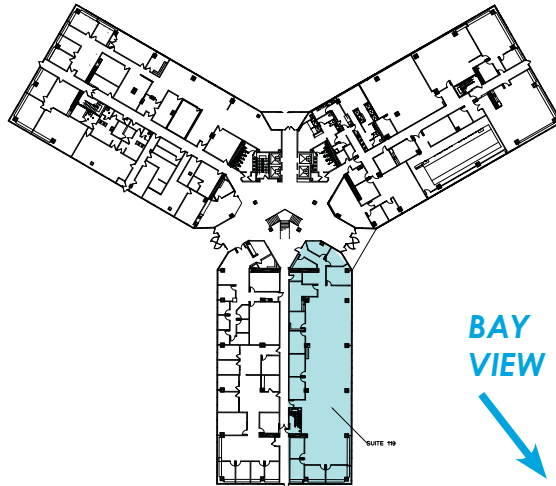


395 OYSTER POINT

OYSTER POINT MARINA PLAZA

SUITE 119 | 6,618 RSF

SOUTH SAN FRANCISCO

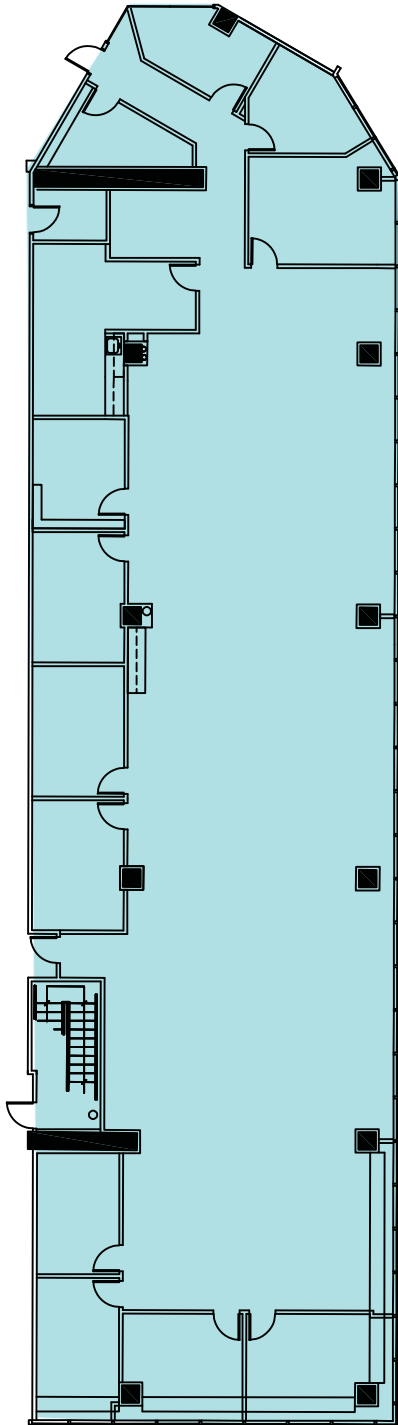

AS-BUILT CONFIGURATION

OFFICES:	9
CONFERENCE ROOM:	1
BREAK ROOM:	1
IT ROOM:	1
STORAGE ROOM:	1
OPEN AREA:	1



For more information, please contact:

SCOTT ENNIS
408.572.1545
scott.ennis@cushwake.com



CLARK STEELE
408.436.3653
clark.steele@cushwake.com

