
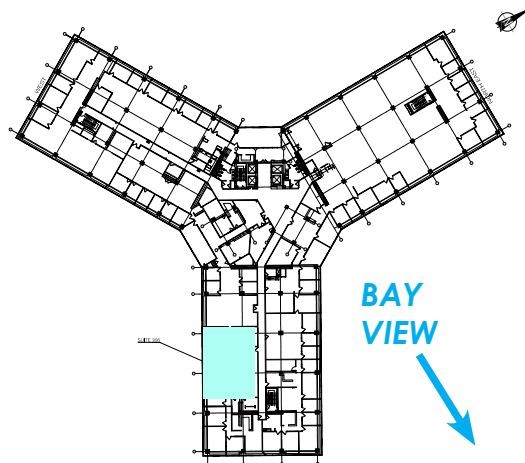


395  
OYSTER POINT

OYSTER POINT MARINA PLAZA SUITE 306 | 3,000 RSF  
SOUTH SAN FRANCISCO

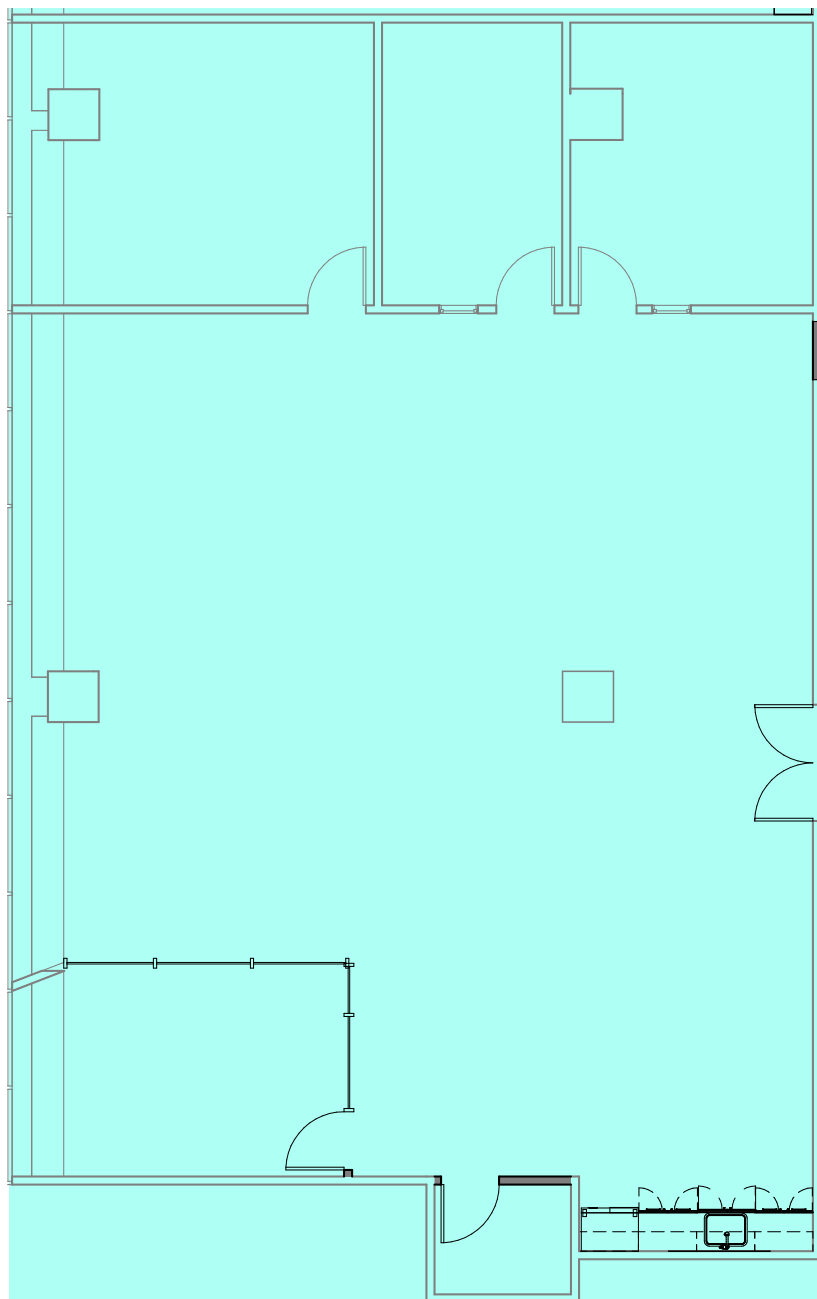

#### AS-BUILT CONFIGURATION

OFFICES:	3
CONFERENCE ROOM:	1
BREAK ROOM:	1
OPEN AREA:	2
IT ROOM:	1
RECEPTION:	1



For more information, please contact:

SCOTT ENNIS  
408.572.1545  
scott.ennis@cushwake.com





CLARK STEELE  
408.436.3653  
clark.steele@cushwake.com



# 395 OYSTER POINT MARINA PLAZA SUITE 306 | 3,000 RSF

## OYSTER POINT SOUTH SAN FRANCISCO

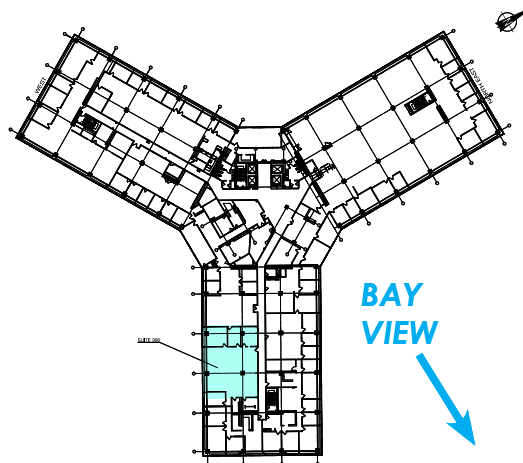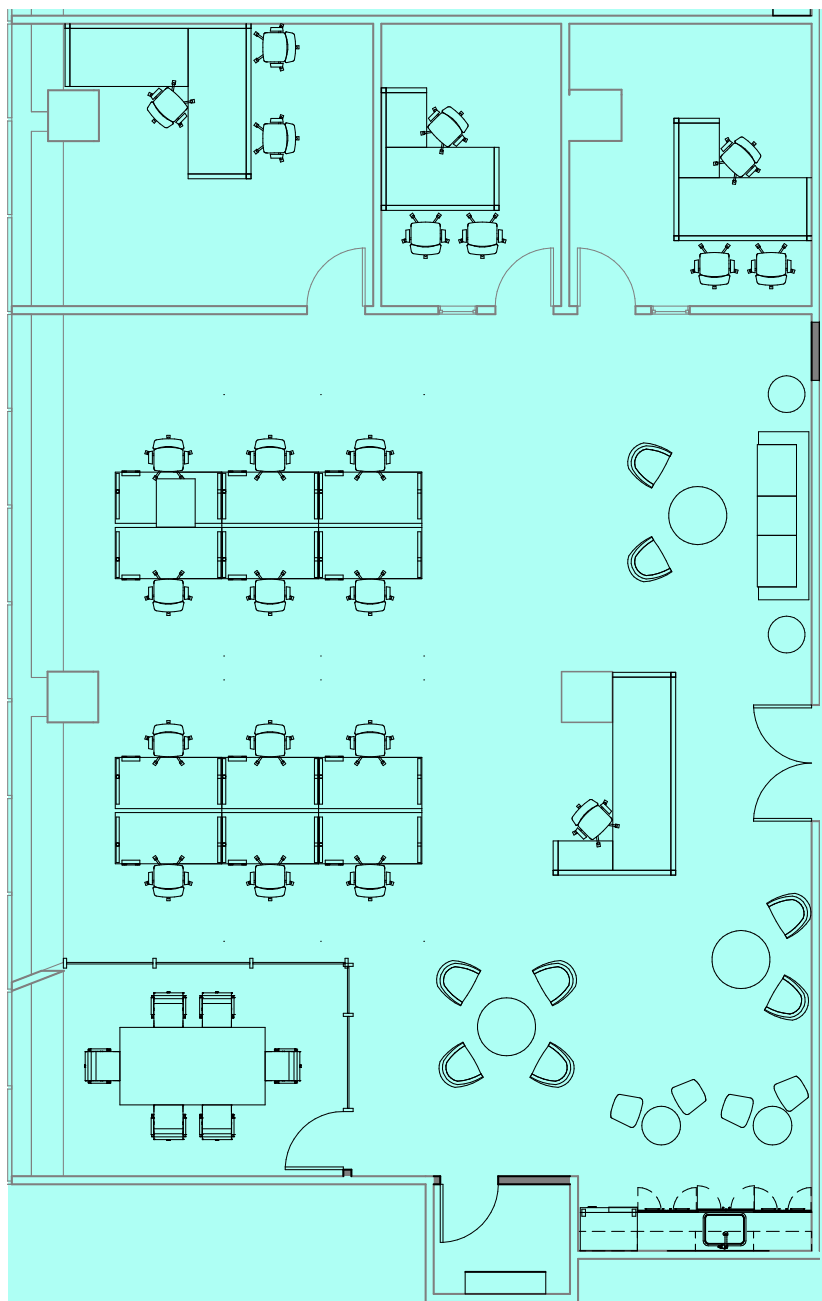

### AS-BUILT CONFIGURATION

OFFICES:	3
CONFERENCE ROOM:	1
BREAK ROOM:	1
OPEN AREA:	2
IT ROOM:	1
RECEPTION:	1



For more information, please contact:

SCOTT ENNIS  
408.572.1545  
scott.ennis@cushwake.com



CLARK STEELE  
408.436.3653  
clark.steele@cushwake.com

