
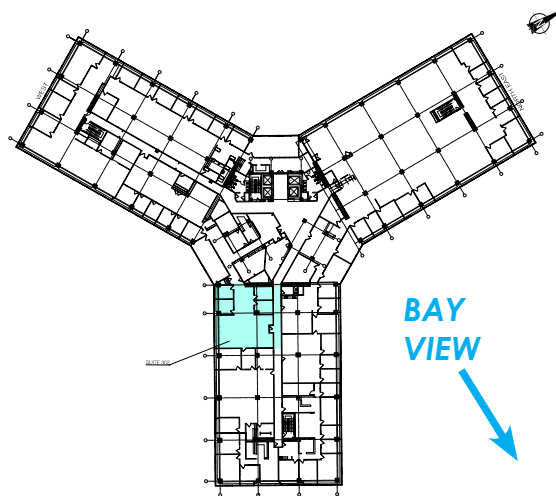


395
OYSTER POINT

OYSTER POINT MARINA PLAZA SUITE 302 | 2,220 RSF
SOUTH SAN FRANCISCO

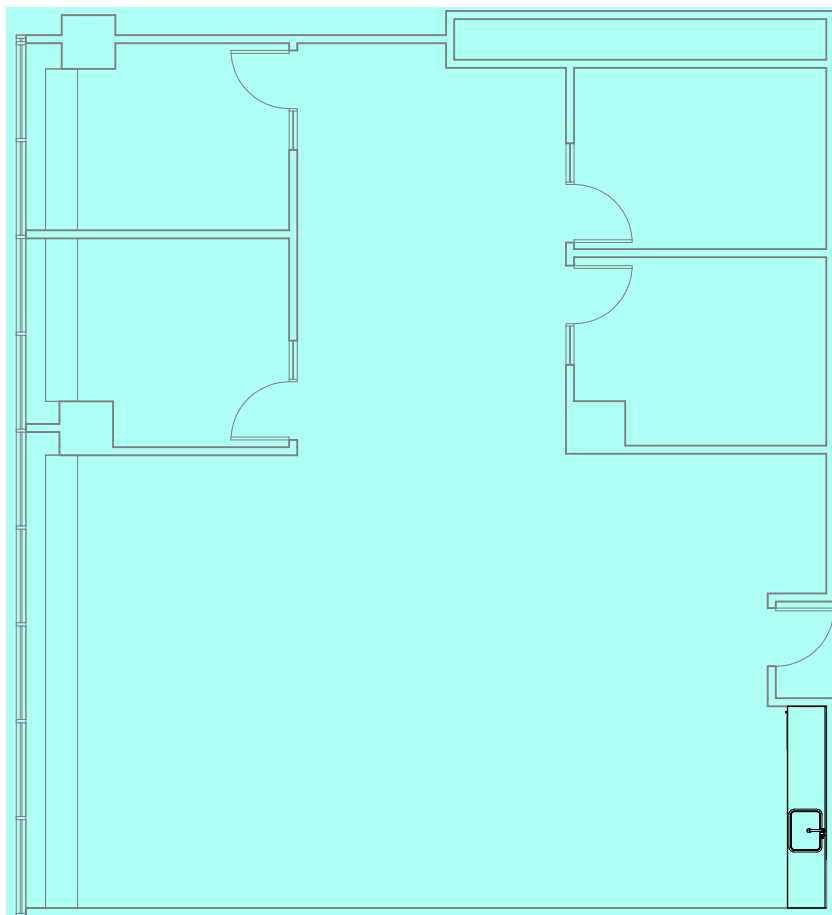

AS-BUILT CONFIGURATION

OFFICES:	3
WET BAR:	1
OPEN AREA:	2
STORAGE ROOM:	1
RECEPTION:	1



For more information, please contact:

SCOTT ENNIS
408.572.1545
scott.ennis@cushwake.com





CLARK STEELE
408.436.3653
clark.steele@cushwake.com



395 OYSTER POINT

OYSTER POINT MARINA PLAZA SUITE 302 | 2,220 RSF
SOUTH SAN FRANCISCO

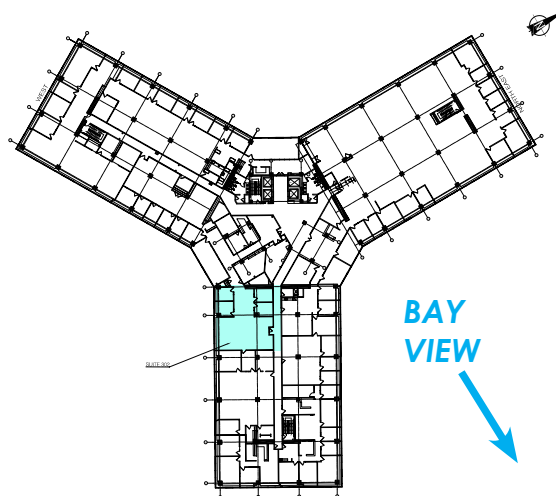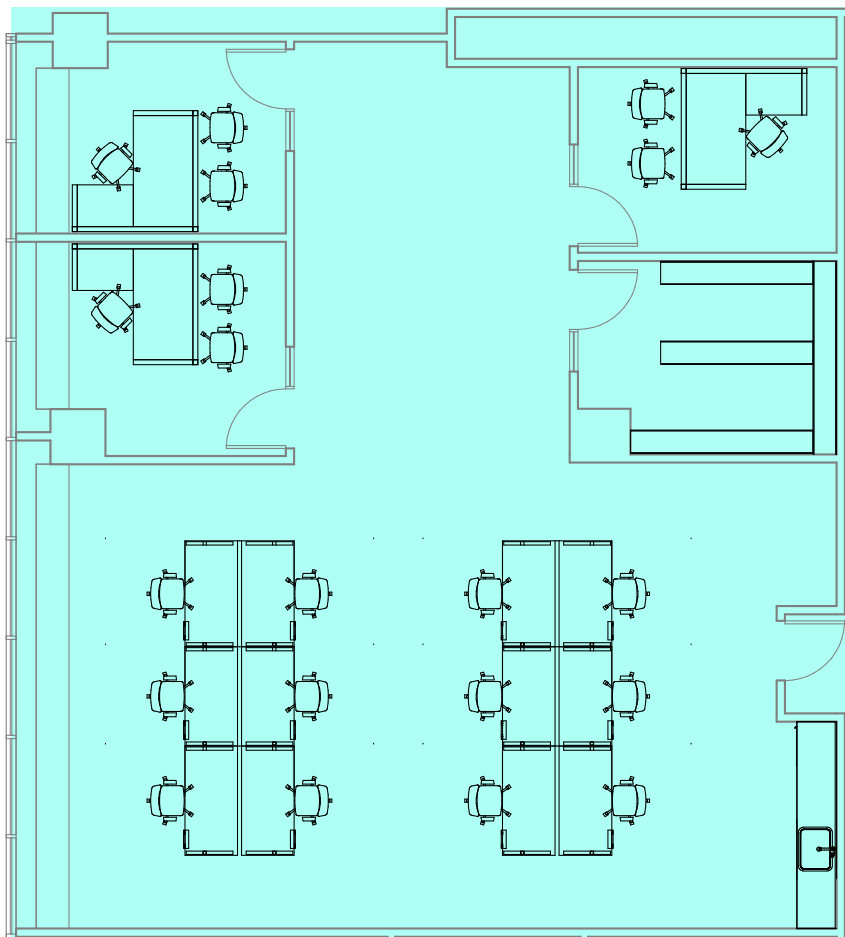

AS-BUILT CONFIGURATION

OFFICES:	3
WET BAR:	1
OPEN AREA:	2
STORAGE ROOM:	1
RECEPTION:	1



For more information, please contact:

SCOTT ENNIS
408.572.1545
scott.ennis@cushwake.com



CLARK STEELE
408.436.3653
clark.steele@cushwake.com

