

395 OYSTER POINT MARINA PLAZA

5,464 USF | 6,566 RSF

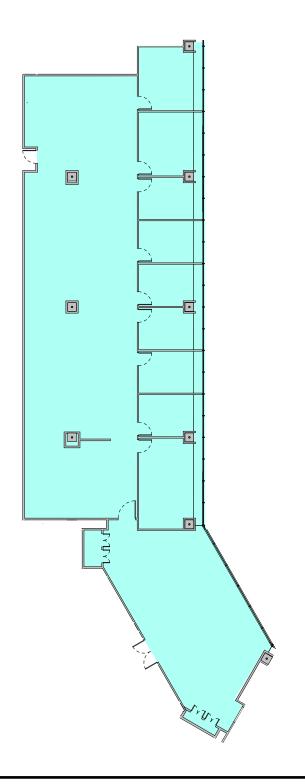

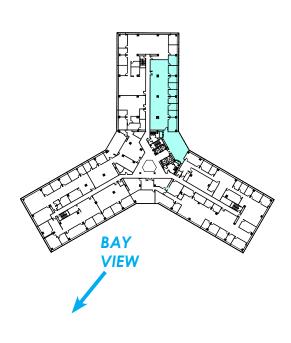

AS-BUILT CONFIGURATION

OFFICES:	8
CONFERENCE ROOM:	1
OPEN AREA:	1
STORAGE CLOSETS:	2
RECEPTION:	1

NE

For more information, please contact:

SCOTT ENNIS 408.572.1545 scott.ennis@cushwake.com



