
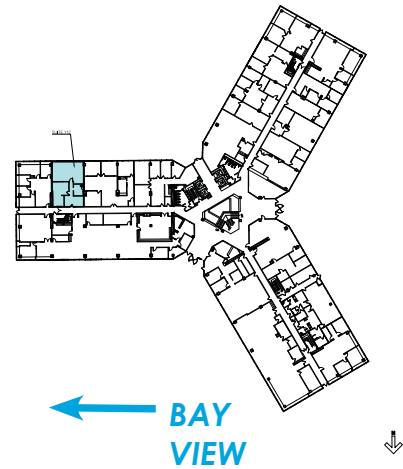


# 400 OYSTER POINT

OYSTER POINT MARINA PLAZA

SUITE 112 | 1,329 RSF

SOUTH SAN FRANCISCO

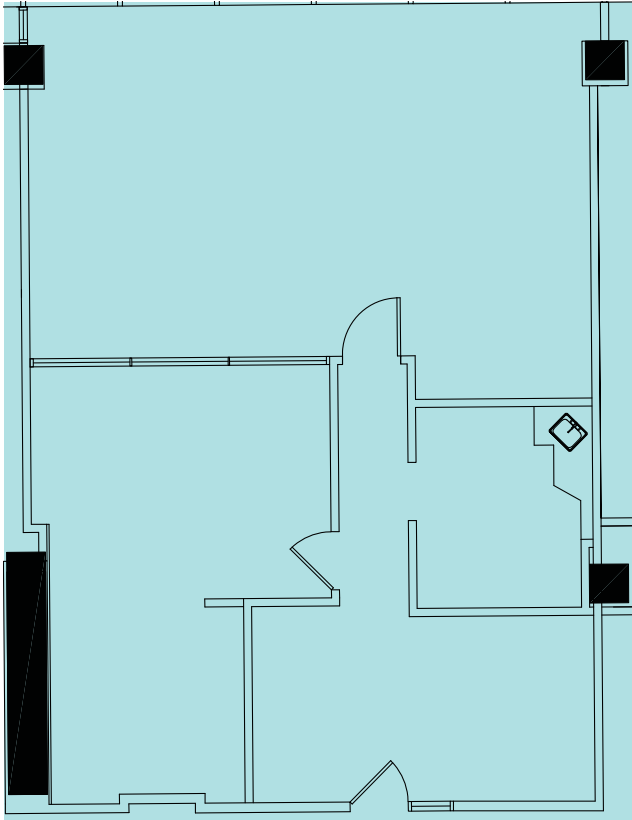

### AS-BUILT CONFIGURATION

OFFICES:	2
CONFERENCE ROOM:	1
KITCHEN:	1
LOUNGE/RECEPTION	1



For more information, please contact:

SCOTT ENNIS  
408.572.1545  
scott.ennis@cushwake.com



CLARK STEELE  
408.436.3653  
clark.steele@cushwake.com

