
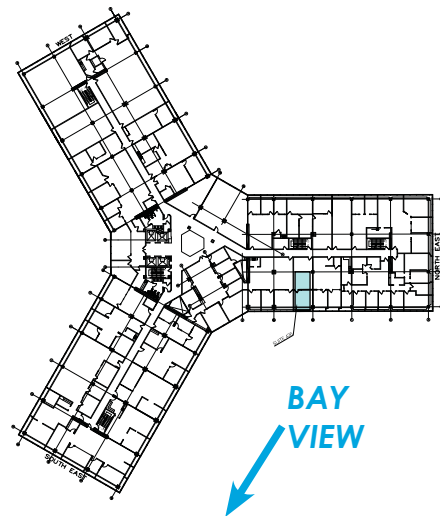


400 OYSTER POINT

OYSTER POINT MARINA PLAZA

SUITE 436 | 748 RSF

SOUTH SAN FRANCISCO

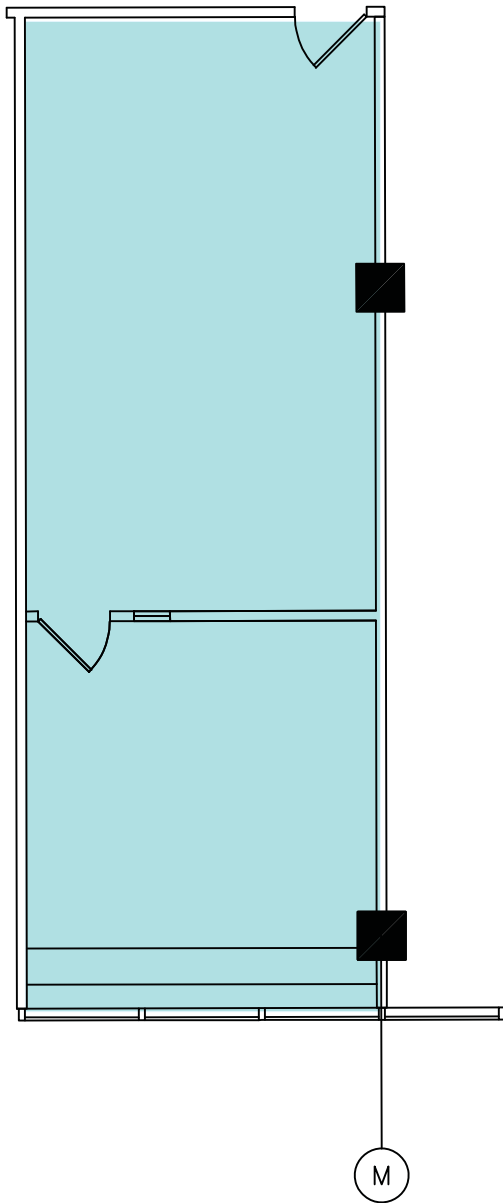

AS-BUILT CONFIGURATION

OFFICES:	1
WORKSTATIONS:	4
RECEPTION:	1



For more information, please contact:

SCOTT ENNIS
408.572.1545
scott.ennis@cushwake.com



CLARK STEELE
408.436.3653
clark.steele@cushwake.com

