395 OYSTER POINT

OYSTER POINT MARINA PLAZA SUITE 120 | 2,775 RSF

SOUTH SAN FRANCISCO

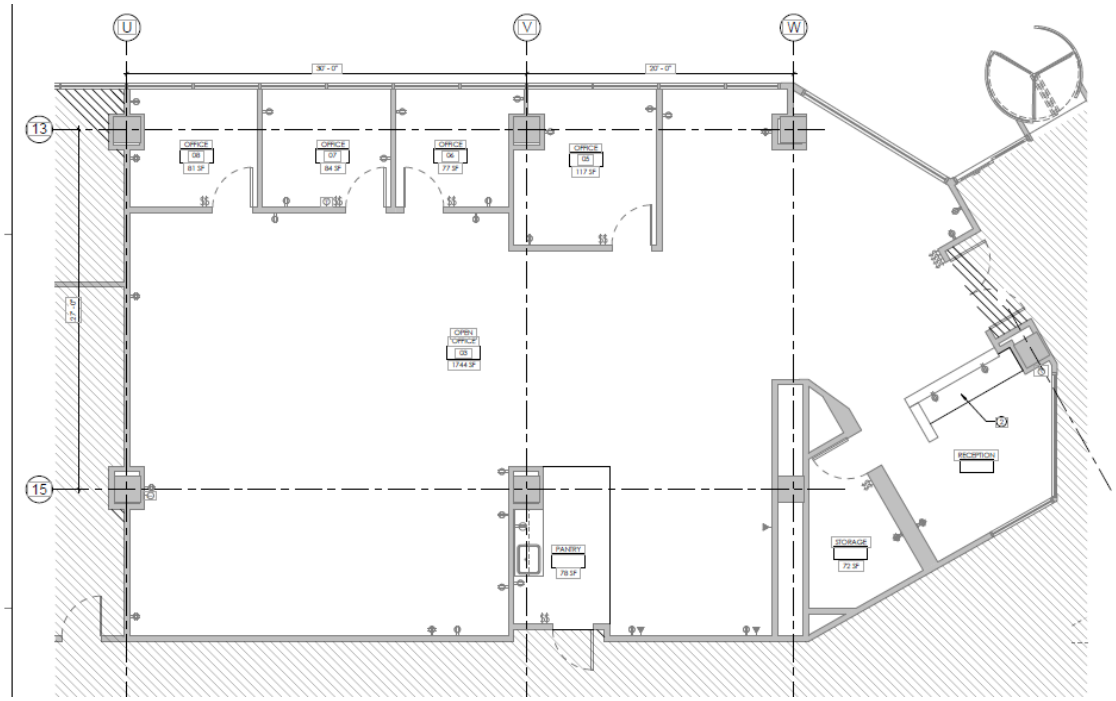

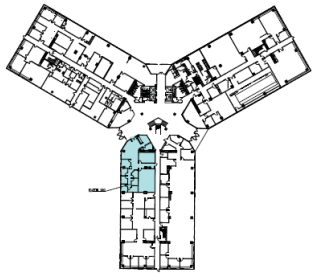

AS-BUILT CONFIGURATION

OFFICES:	4
STORAGE ROOM:	1
RECEPTION:	1

For more information, please contact:

SCOTT ENNIS
408.572.1545
scott.ennis@cushwake.com

CUSHMAN & WAKEFIELD®

CLARK STEELE
408.436.3653
clark.steele@cushwake.com

OYSTER POINT MARINA PLAZA